
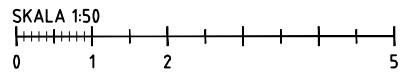


BET	ÄNDRINGEN AVSER	SIGN	DATUM
RELATIONSHANDLING			
LUNDBY PARK KUBIK Rambergsstaden 74:2, Göteborg			
SKANSKA			
A	BORNSTEN LYCKEFGORS ARKITEKTER AB		18.09-2009
K	INTEGRA ENGINEERING AB		18.09-2009
CPM	CPM AB		18.09-2009
KP	BOE BOK, LÅN ÖFFENTLIG		18.09-2009
E	RELLERS SVENGE AB		18.09-2009
V	VVSHELD AB		18.09-2009
W	VVSHELD AB		18.09-2009
M	MARK		18.09-2009
LUPPDRAG NR 217054 RITAD/KONSTR AV AAN HANDEL AGGARE MEK			
DATUM 2020-02-24 ANSVARIG MARTIN EK			
Nybyggnation bostäder LUFTHANDLINGSSYSTEM PLAN 10-1 DEL 17			
SKALA A1: 1:50 A3: 1:100	NUMMER	BET	
	V-57-1-1710-1		

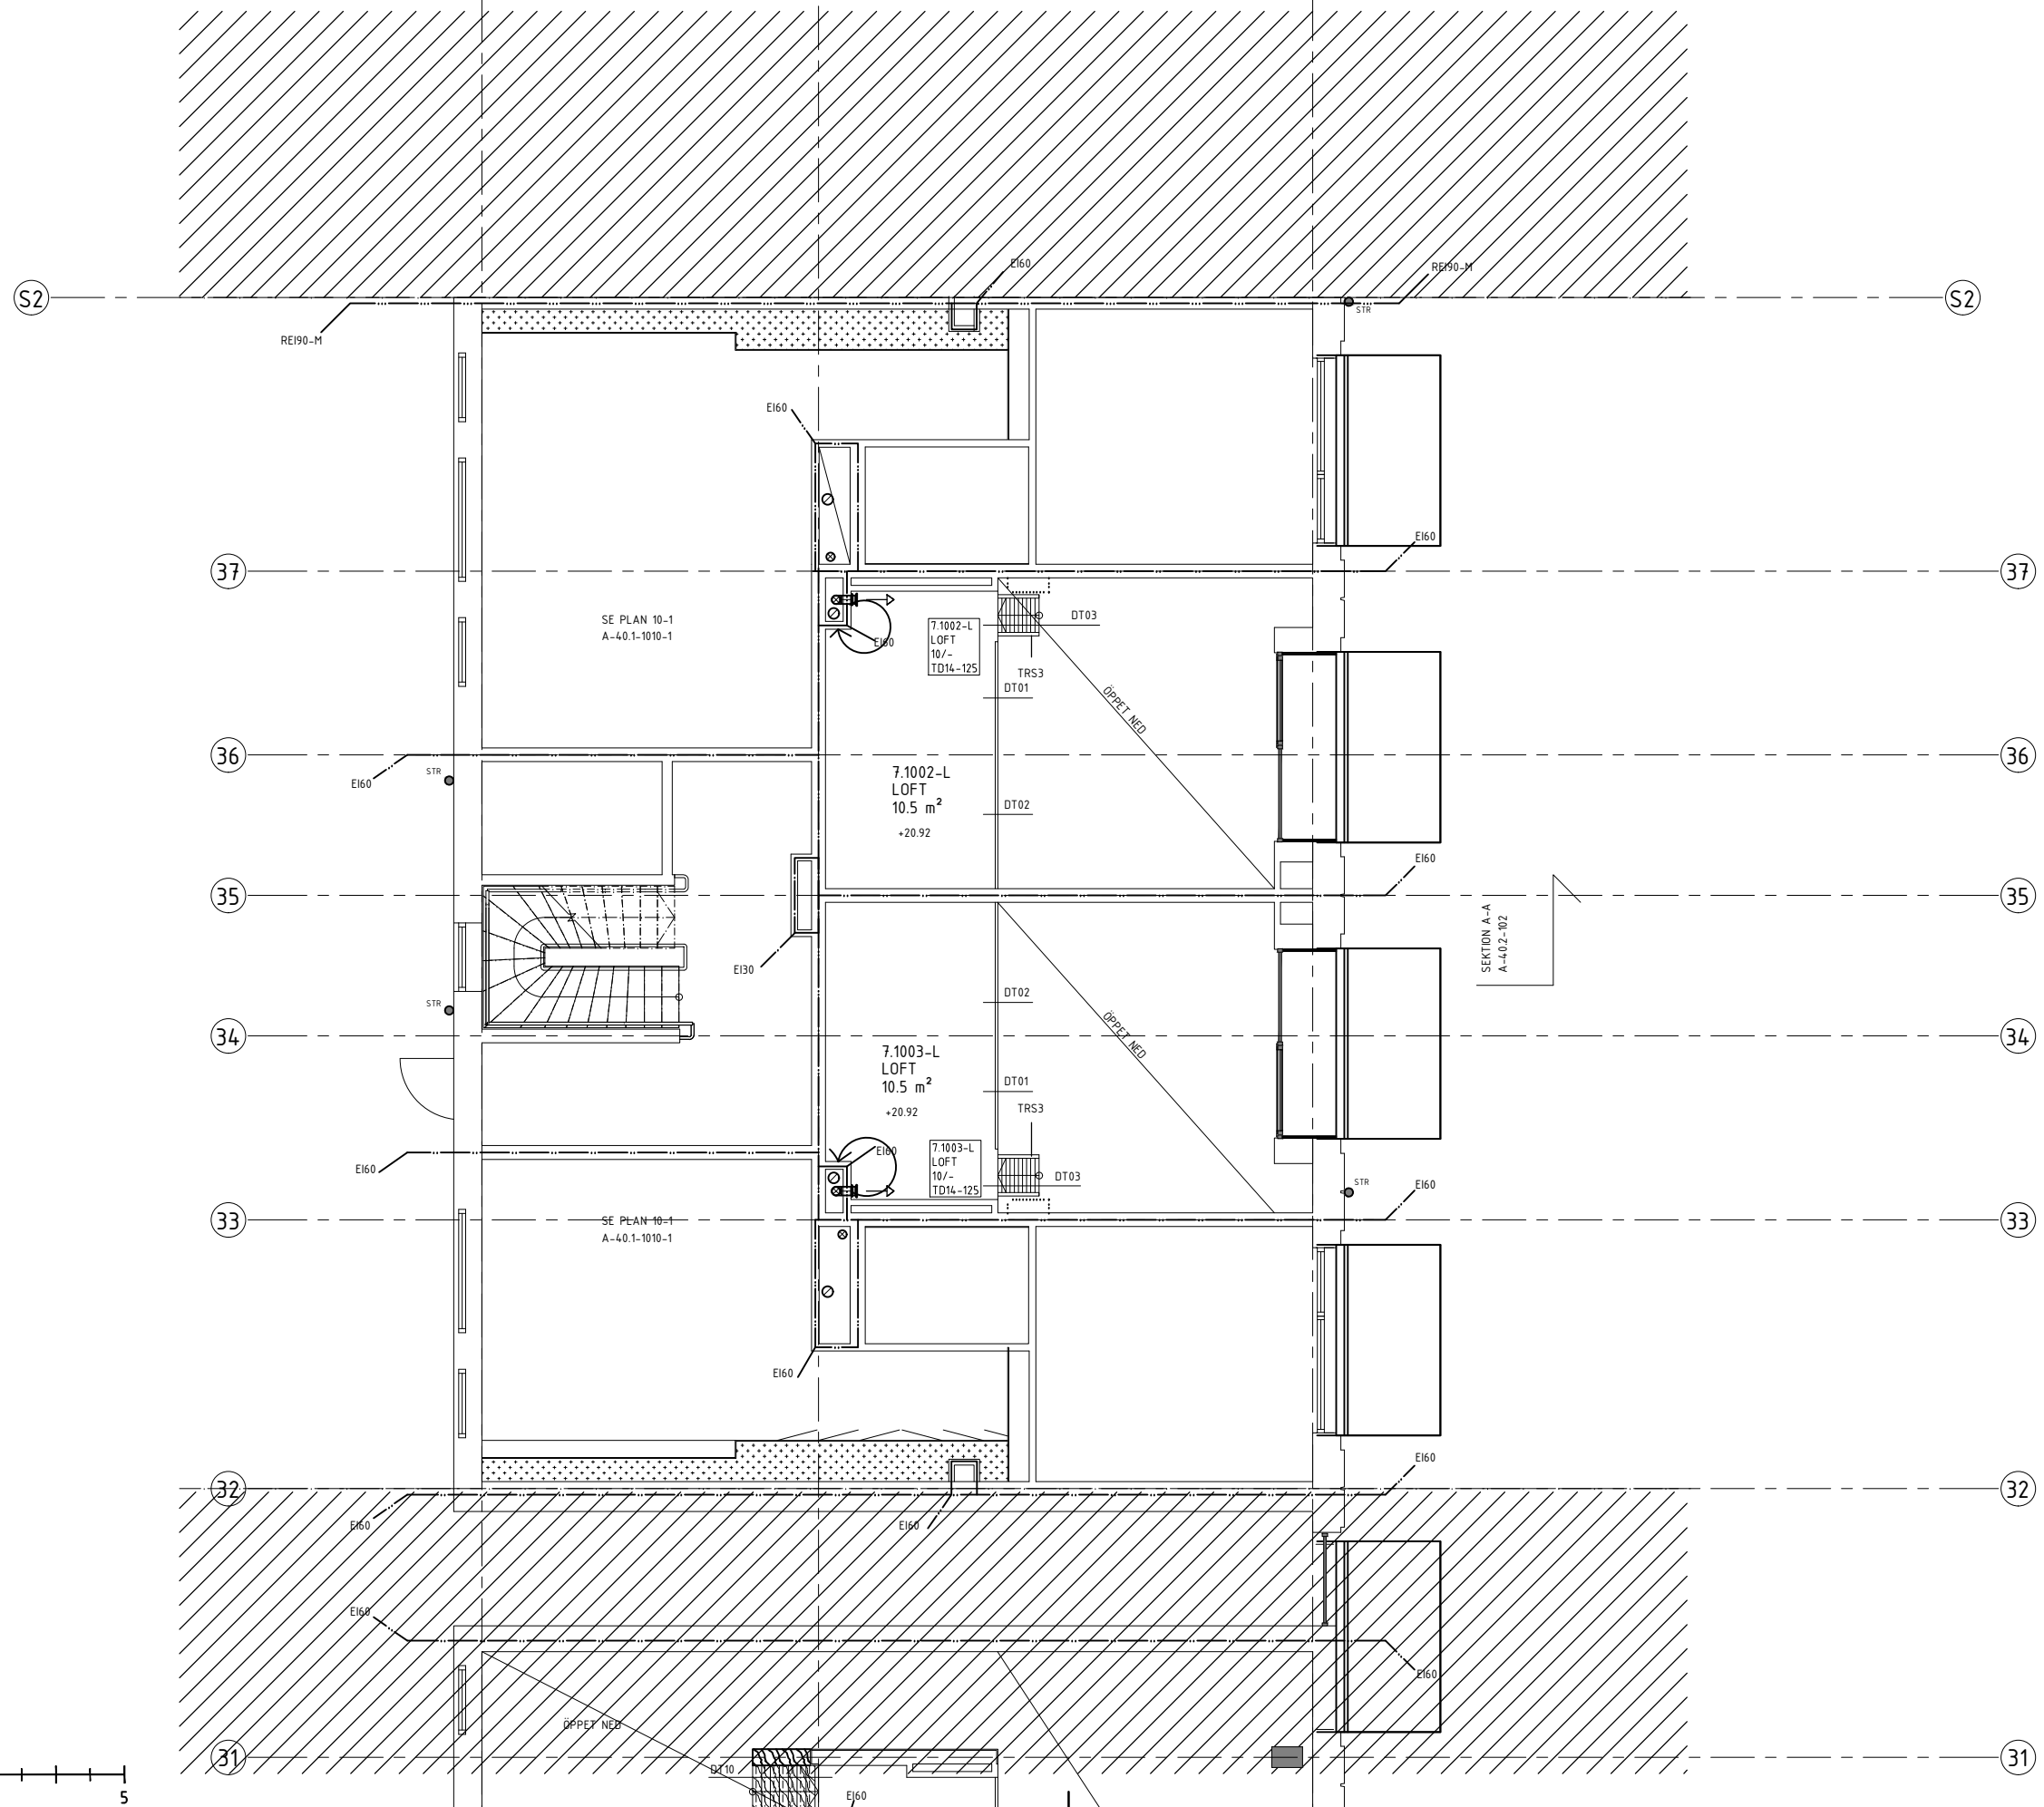

BET	ÄNDRING AVSEER	SIGN	DATUM
RELATIONSHANDLING			
LUNDBY PARK KUBIK Rambergsstaden 74:2, Göteborg			
SKANSKA			
A	BORNSTEN LYCKEFGORS ARKITEKTER AB		18.09.2019
K	INTEGRA ENGINEERING AB		18.09.2019
KP	COVA AB		18.09.2019
E	RELLERS SVENGE AB		18.09.2019
V	VVSHELD AB		18.09.2019
W	VVSHELD AB		18.09.2019
M	MARK		18.09.2019
UPPDRAG NR 217054		RITAD/KONSTR AV AAN	HANDELAGGARE MEK
DATUM 2020-02-24		ANSVARIG MARTIN EK	
Nybyggnation bostäder LUFTHANDLINGSSYSTEM PLAN 10-2 DEL 17			
SKALA A1: 1:50 A3: 1:100	NUMMER V-57-1-1710-2	BET	