
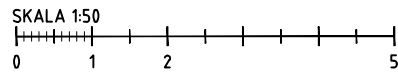


ÖVERLAPPLING FASAD
SAMORDNAS MED GRANNFASTIGHET

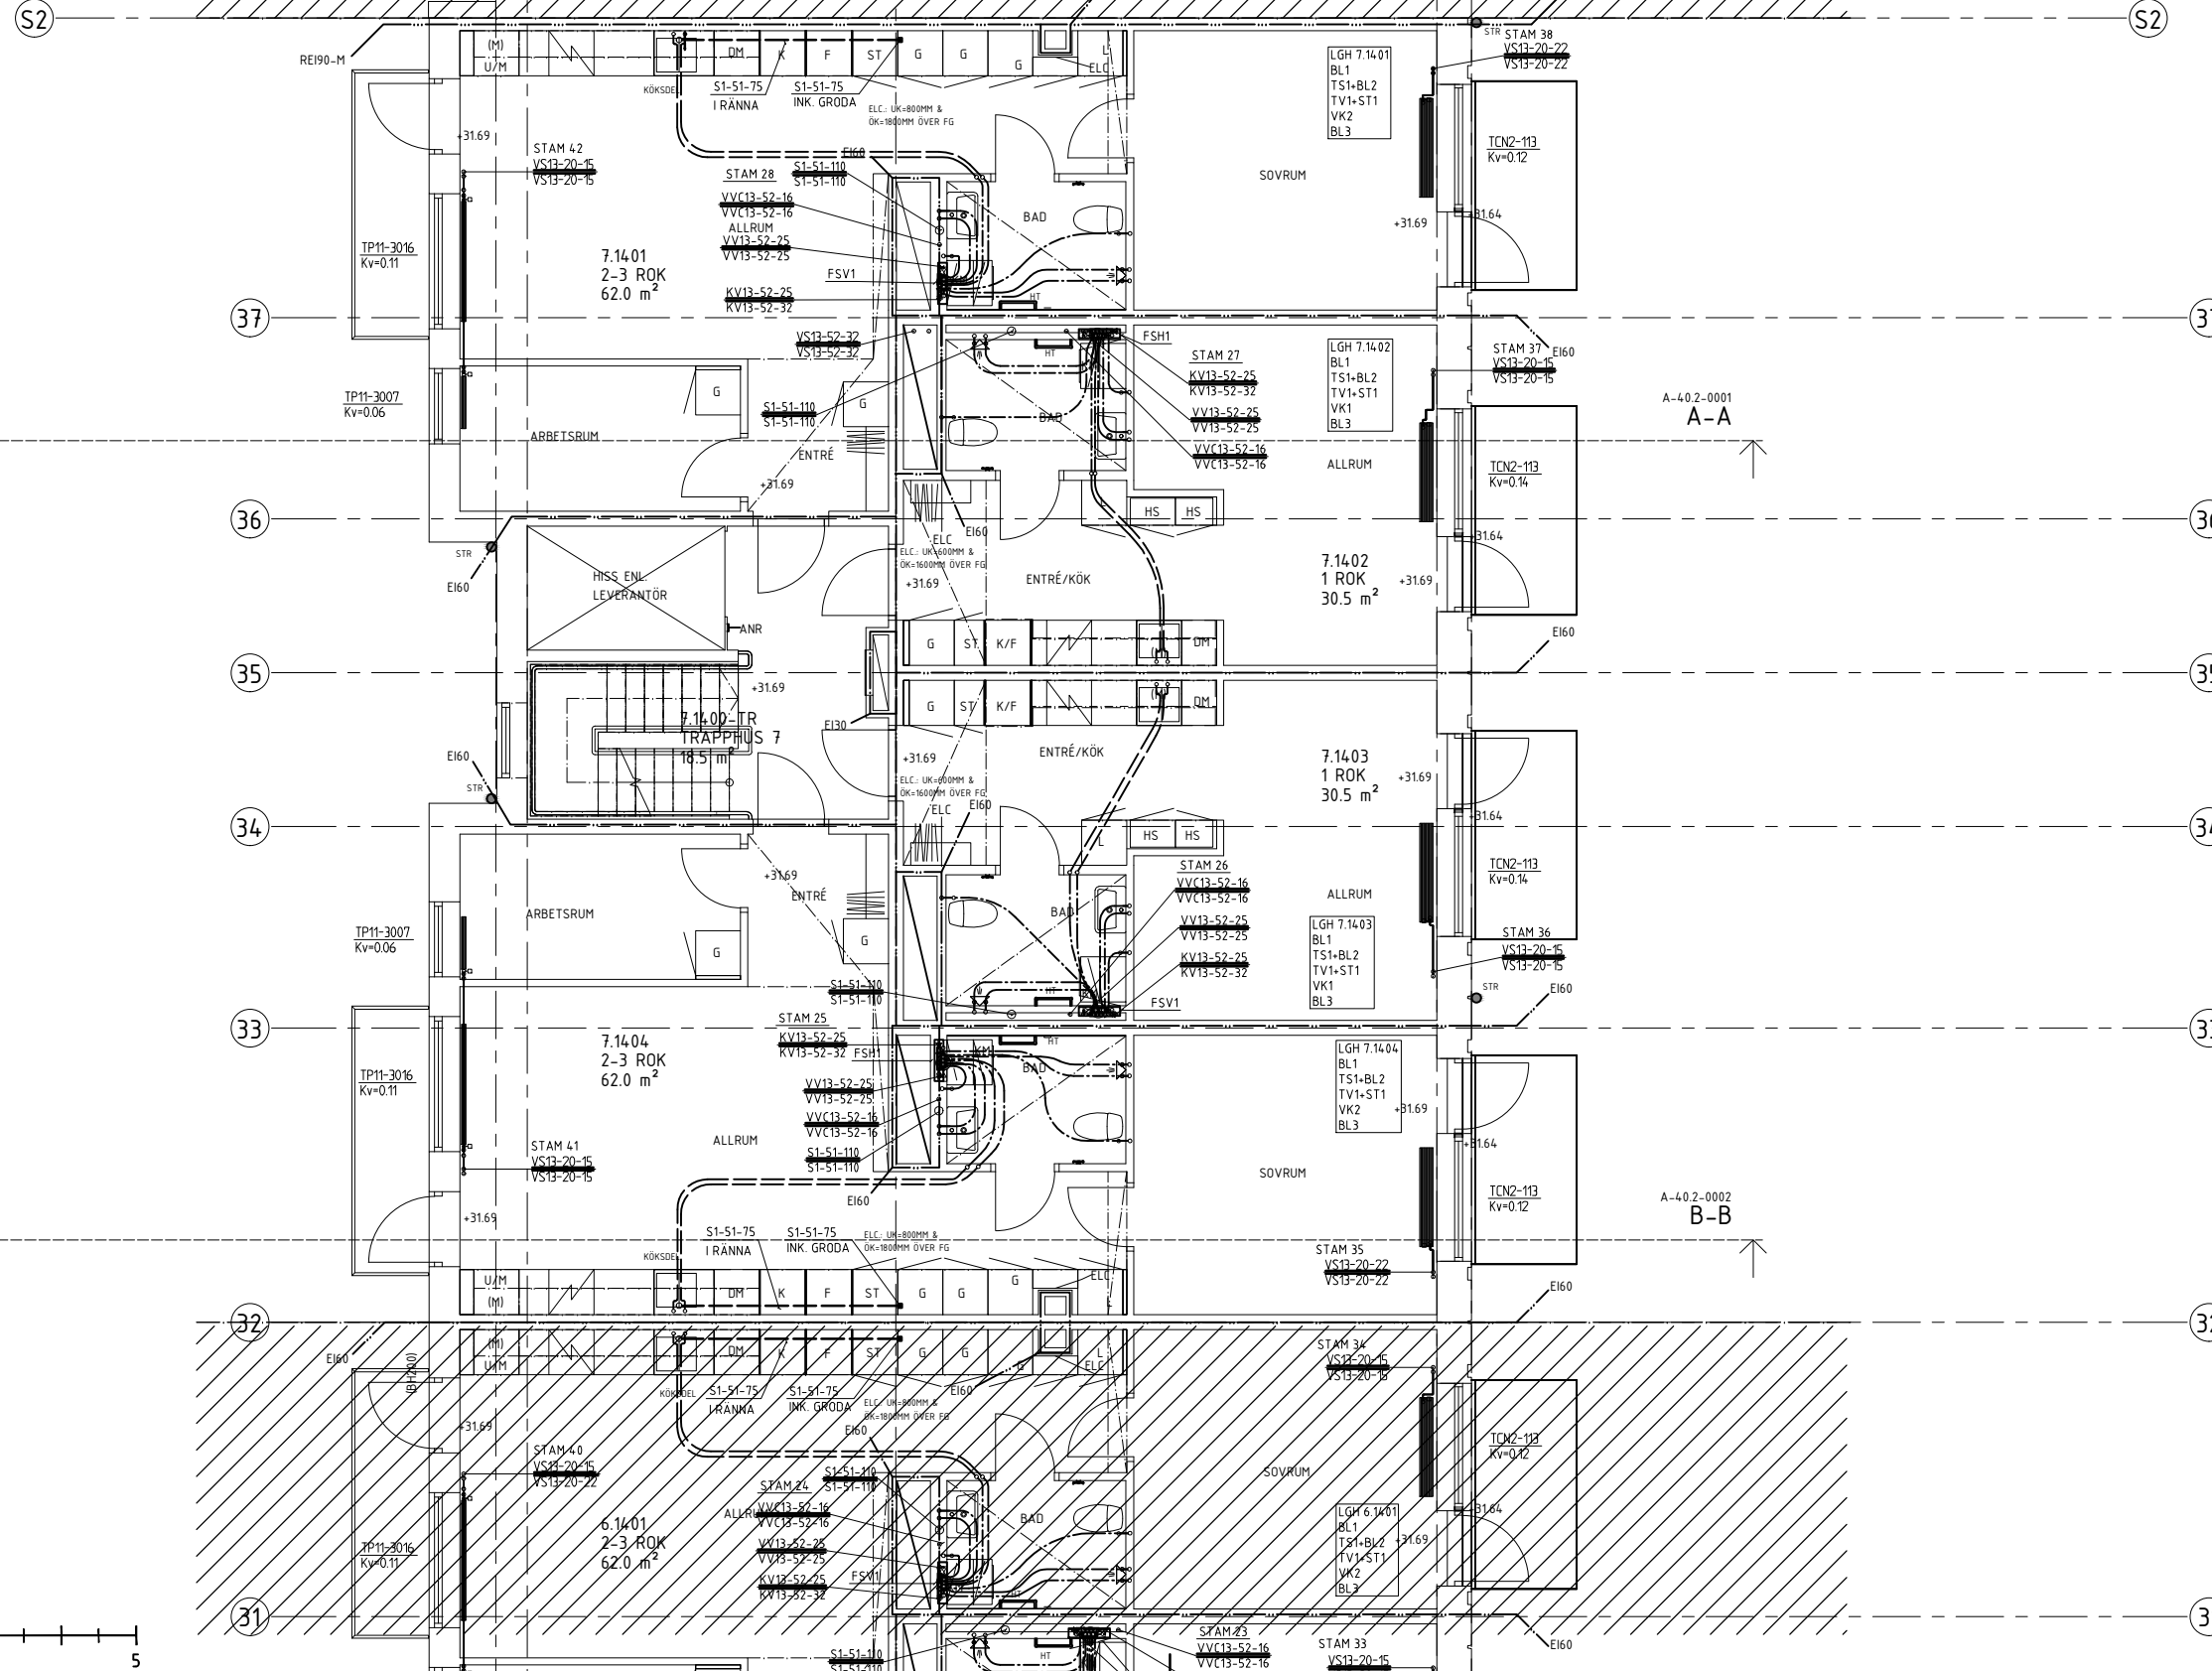

BET	ÄNDRINGEN AVSER	SIGN	DATUM
RELATIONSHANDLING			
LUNDBY PARK KUBIK Rambergsstaden 74:2, Göteborg			
SKANSKA			
A	BORNSTEN LYCKEFGORS ARKITEKTER AB		70.400-200002
K	INTEGRA ENGINEERING AB		70.400-200001
CPM	CPM AB		70.400-200000
KP	BOE BROS, LÅN ÖFFENTLIG		70.400-200000
E	RELLERS SVENGE AB		70.400-200000
V	VVSHELD AB		70.400-200000
W	VVSHELD AB		70.400-200000
M	MARK		70.400-200000
LUPPDRAG NR 217053			
DATUM 2020-02-24		RITAD/KONSTR AV AAN	HANDEL AGGARE MEK
ANSVARIG MARTIN EK			
Nybyggnation bostäder			
RÖRANLÄGGNING			
PLAN 14			
DEL 17			
SKALA A1: 1:50	NUMMER	BET	
A3: 1:100	W-50-1-1714		