

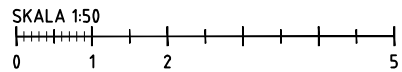


BET	ÄNDRINGEN AVSER	SIGN	DATUM
<b>RELATIONSHANDLING</b>			
<b>LUNDBY PARK KUBIK</b> Rambergsstaden 74:2, Göteborg			
<b>A</b>	BORNSTEN LYCKEFORS ARKITEKTER AB	100.000-00000	
<b>K</b>	INTEGRA ENGINEERING AB	100.000-00000	
<b>COMI</b>	COMI AB	100.000-00000	
<b>KP</b>	BOE BILBY, LINDH & ÖSTBERG	100.000-00000	
<b>E</b>	RELLERS SVENIGE AB	100.000-00000	
<b>V</b>	VVS&KLIM AB	100.000-00000	
<b>W</b>	VVS&KLIM AB	100.000-00000	
<b>M</b>	MARK	100.000-00000	
LUPPDRAG NR 217054			
DATUM 2020-02-24		RITAD/KONSTR AV AAN	HANDEL AGGARE MEK
Nybyggnation bostäder			
LUFTHANDLINGSSYSTEM			
PLAN 10-1			
DEL 14			
SKALA A1: 1:50 A3: 1:100	NUMMER V-57-1-1410-1	BET	

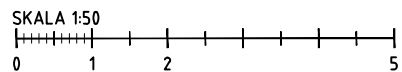

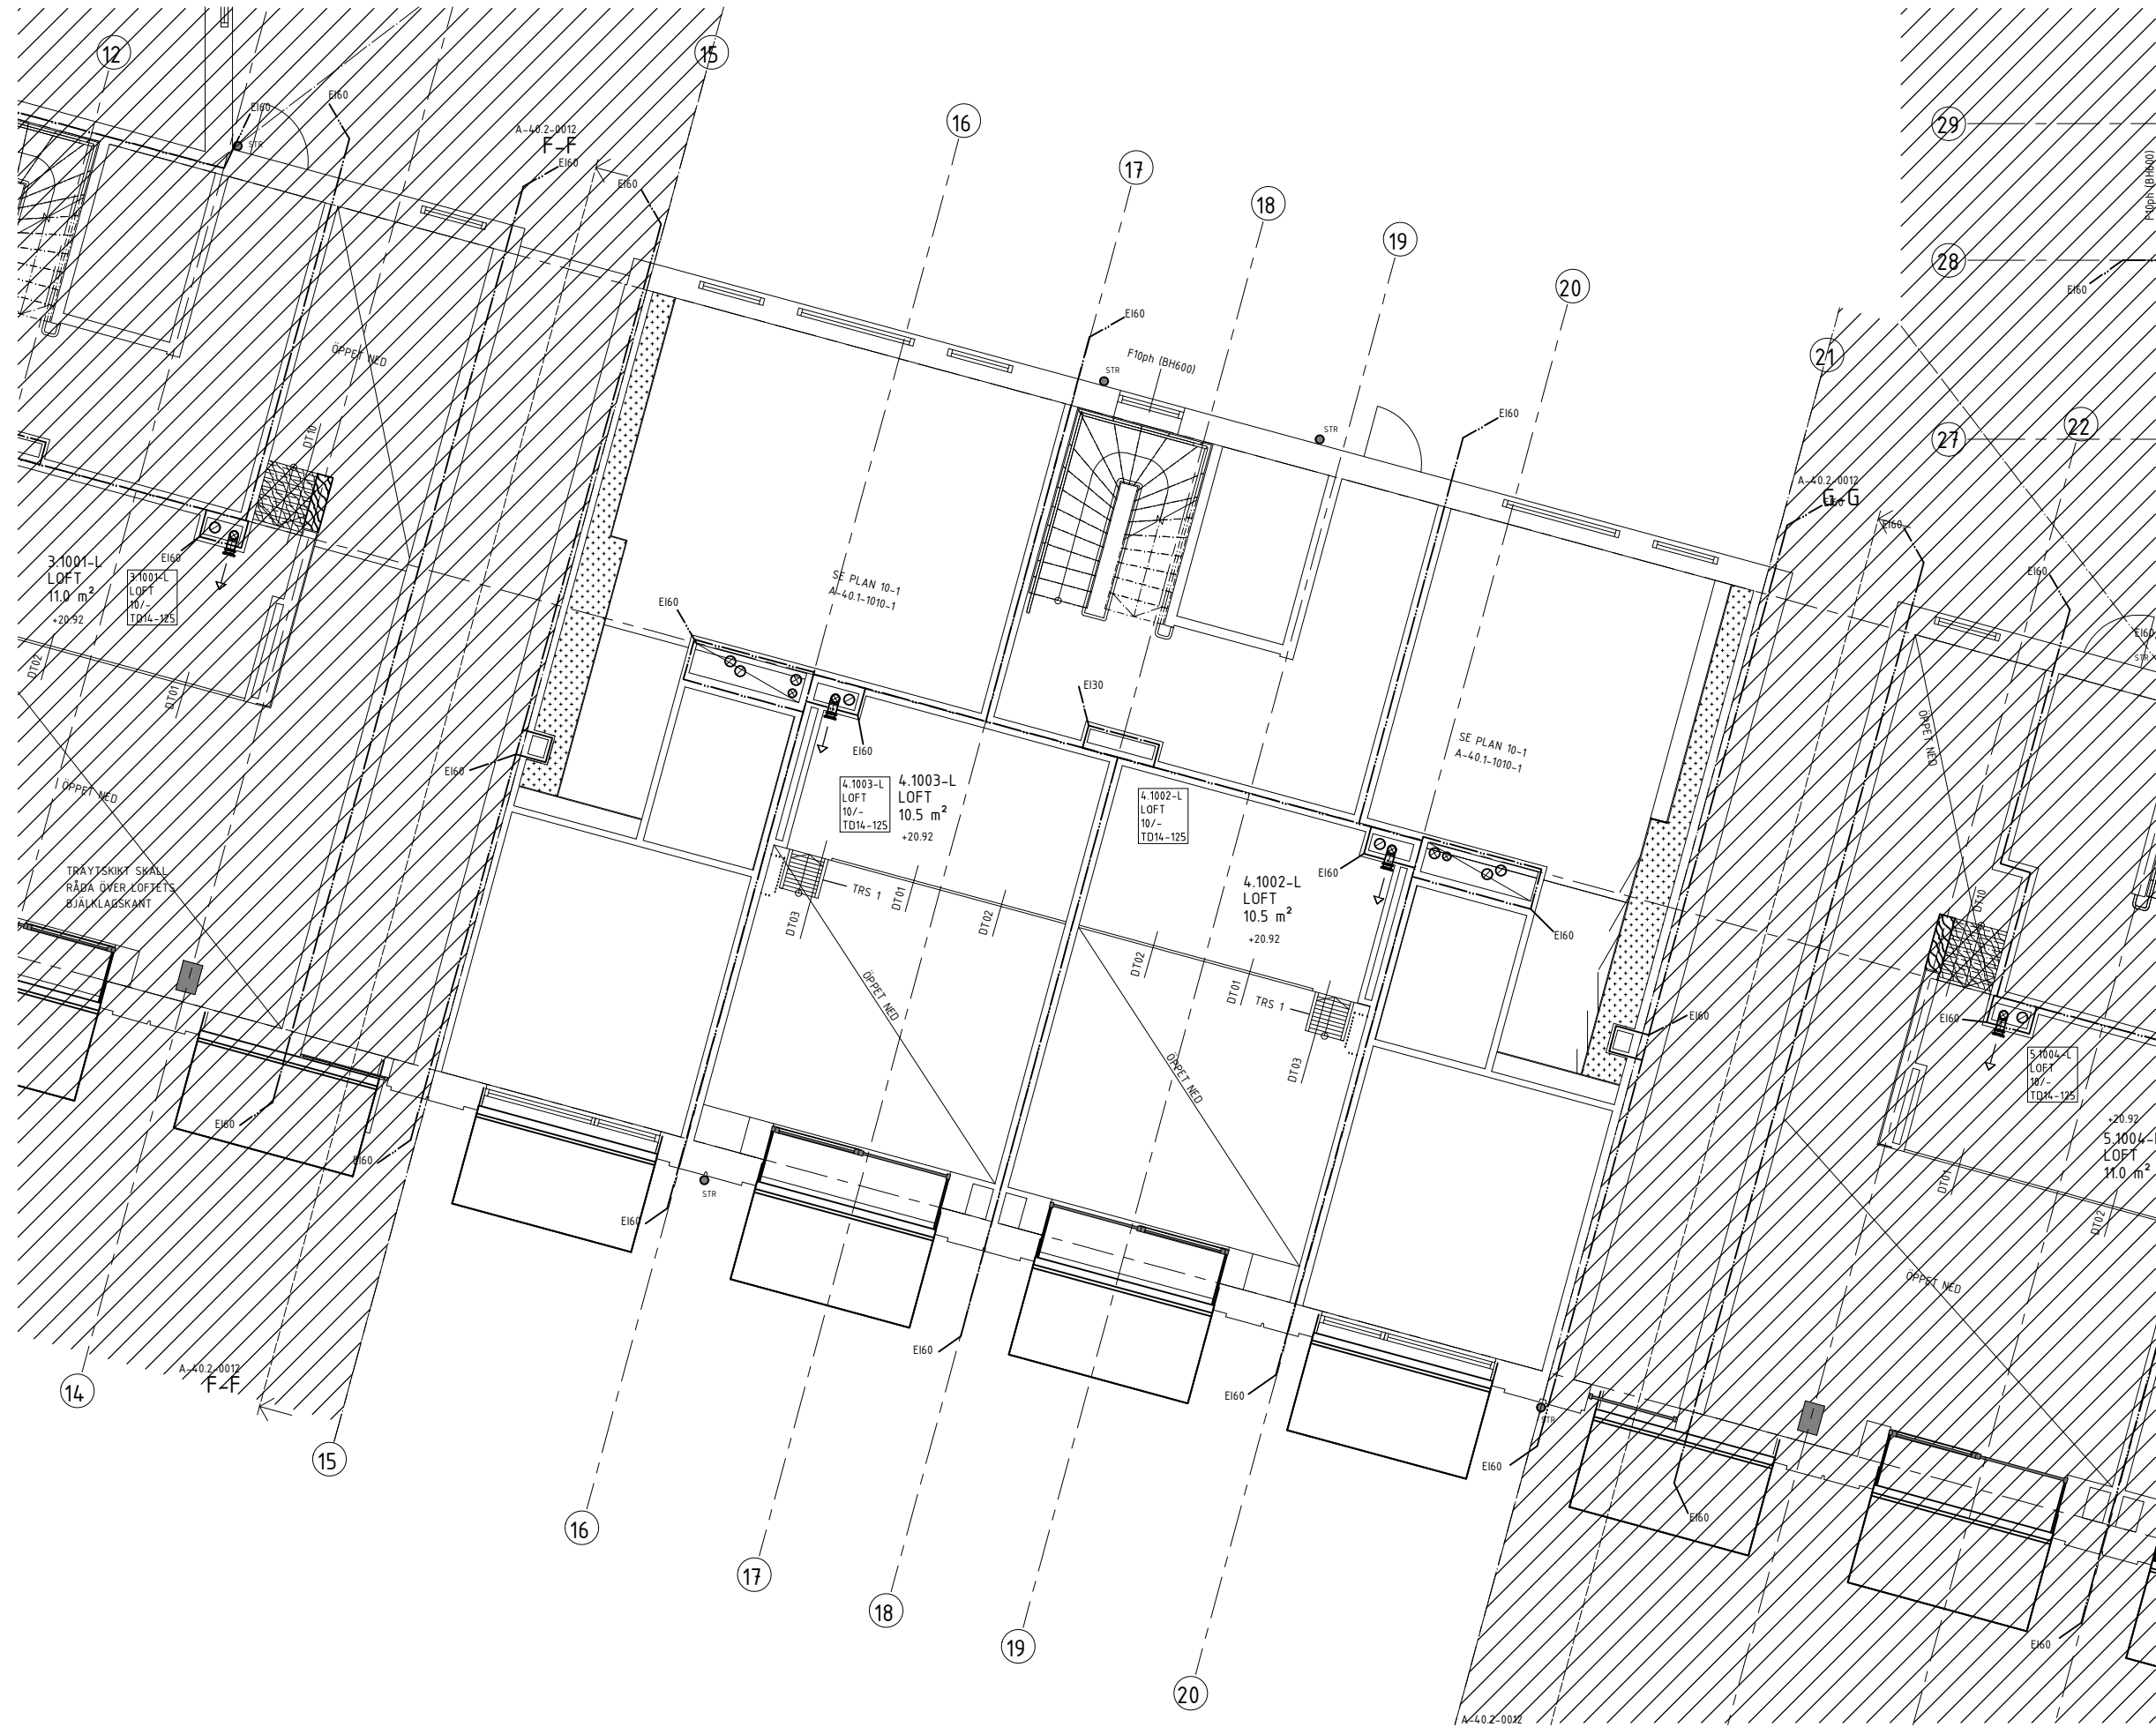

BET	ÄNDRINGEN AVSER	SIGN	DATUM
<b>RELATIONSHANDLING</b>			
<b>LUNDBY PARK KUBIK</b> Rambergsstaden 74:2, Göteborg			
A	BORNSTEN LYCKEFORS ARKITEKTER AB		18.09-2000
K	INTEGRA ENGINEERING AB		18.09-2000
CPM	CPM AB		18.09-2000
KP	BOE BOK, LÅN ÖFFENTLIG		18.09-2000
E	RELLERS SVENGE AB		18.09-2000
V	VYSHEL AB		18.09-2000
W	VYSHEL AB		18.09-2000
M	MARK		18.09-2000
UPPDRAG NR		RITAD/KONSTR AV	HANDELSAGGARE
217054		AAN	MEK
DATUM		ANSVARIG	
2020-02-24		MARTIN EK	
Nybyggnation bostäder			
LUFTHANDLINGSSYSTEM			
PLAN 10-2			
DEL 14			
SKALA	NUMMER	BET	
A1: 1:50 A3: 1:100	V-57-1-1410-2		