


A-50.2-0001
A-A

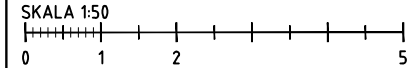

BET	ÄNDRINGEN AVSER	SIGN	DATUM
RELATIONSHANDLING			
LUNDBY PARK KUBIK Rambergsstaden 74:2, Göteborg			
SKANSKA			
A	BORNSTEN LYCKEFORS ARKITEKTER AB		18.09-2000
K	INTEGRA ENGINEERING AB		18.09-2000
CPM	CPM AB		18.09-2000
KP	BOE BOK, LÅN ÖFFENTLIG		18.09-2000
E	RELLERS SVENGE AB		18.09-2000
V	VVSHELD AB		18.09-2000
W	VVSHELD AB		18.09-2000
M	MARK		18.09-2000
LUPPDRAG NR 217054			
RITAD/KONSTR AV AAN		HANDL AGGARE MEK	
DATUM 2020-02-24			
ANSVARIG MARTIN EK			
Nybyggnation bostäder			
LUFTBEHANDLINGSSYSTEM			
PLAN 13			
DEL 11			
SKALA A1: 1:50 A3: 1:100	NUMMER V-57-1-1113	BET	